

FIG. 4



Redline sheet "indicating drawing
amendments in red in"

417

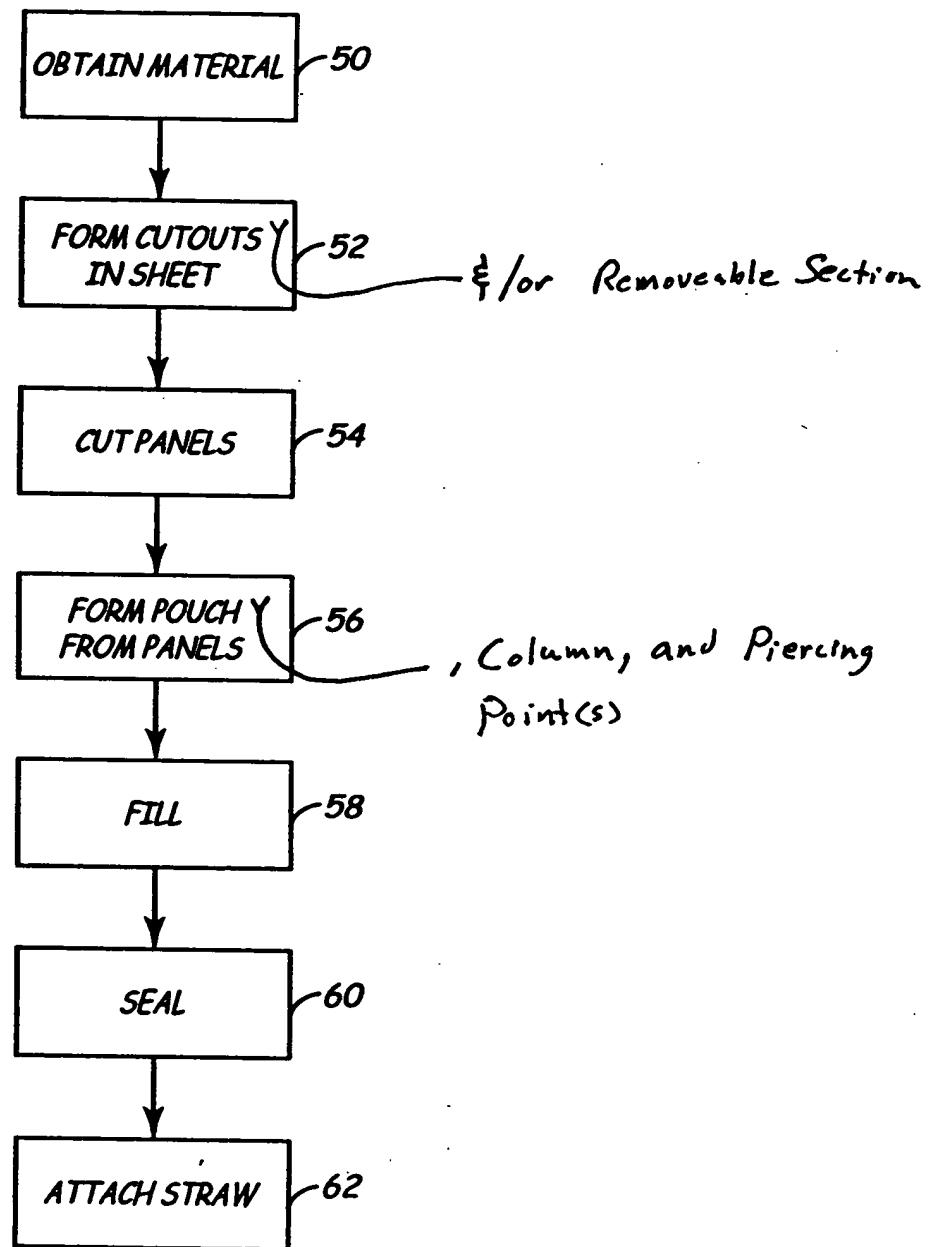


FIG. 4